

TO ESTABLISH GEOMETRIC CONTROL FOR THE CONSTRUCTION OF THIS PROJECT, THE DEPARTMENT HAS PROVIDED THE FOLLOWING INFORMATION:

- Format *
 3D Design Modeling Electronic Files AutoCad C3D
 Horizontal Control Control Diagram
 Vertical Control Control Diagram
 Roadway Alignment Plan Sheet/AutoCad C3D
 Original Terrain Data _____
 Other: _____

* Specify the information format, ie., plan sheet, computer disk, computer printout, or other. The information marked is either contained on the plans or is available from the Engineer.

TYPE OF PROJECT

- | | |
|---|--|
| <input type="checkbox"/> Landscaping | <input checked="" type="checkbox"/> Major Reconstruction |
| <input type="checkbox"/> Signalization | <input type="checkbox"/> New Roadway Construction |
| <input type="checkbox"/> Safety Improvement | <input type="checkbox"/> Bridge Replacement |
| <input type="checkbox"/> Asphalt Overlay | <input type="checkbox"/> Bridge Widening |
| <input type="checkbox"/> Concrete Overlay | <input type="checkbox"/> New Bridge |
| <input type="checkbox"/> Minor Widening | <input type="checkbox"/> Other: _____ |

SURVEY WORK TO BE PERFORMED BY OTHERS: _____

WORK PERFORMED BY THE CONTRACTOR'S SURVEYOR UNDER SECTION 625:

- A complete passing Base Line report (completed within 6 months prior to the start of the project)
- An instrument calibration Certification (completed within 6 months prior to the start of the project)
- Establish and Maintain Project Centerline or Engineer Approved Offset Line(s)
- Verification and Maintenance of Horizontal and Vertical Control
- Verify or Determine existing grades and alignments
- Verify or Determine existing topography
- Clearing and Grubbing Limits (Section 201)
- Removal Limits (Section 202)
- Reset Items (Section 210)
- Excavation and Embankment (Section 203)

- Excavation
- Unclassified
 - Stripping
 - Muck
 - Rock
 - Borrow
 - Other: _____
 - Potholing

- Embankment
- Site Grading
 - Erosion Control (Perm)
 - Other: _____
 - As Staked Earthwork Quantities (See General Notes)

- Landscaping
- Top Soil (Section 207)
 - Seeding (Section 212)
 - Mulching (Section 213)
 - Planting (Section 214)
 - Herbicide (Section 217)
 - Other: _____

- Erosion Control (Section 208)
- Seeding (Temp)
 - Silt Fence
 - Erosion Bales
 - Erosion Logs
 - Riprap (Temp)
 - Other: _____

- Roadway Bases
- Untreated Subgrade
 - Treated Subgrade
 - Aggregate Base Course (Section 304)
 - Reconditioning
 - PMBB - Plant Mix Bituminous Base
 - Other: _____

	Slope Staking (Y/N)	Grid (Y/N)	Grade (Y/N)	Special Interval
Excavation	Y	N	Y	-
	-	-	-	-
	-	-	-	-
	-	-	-	-
Embankment	Y	N	Y	-
	-	-	-	-
	-	-	-	-
	-	-	-	-

(R-1)

Roadway Bases	Grid (Y/N)	Grade (Y/N)	Special Interval	Special Offset
-	-	-	-	-
-	-	-	-	-
N	Y	-	-	-
-	-	-	-	-
-	-	-	-	-
-	-	-	-	-

- Pavements
- HMA - Hot Mix Asphalt (Section 403)
 - Concrete (Section 412)
 - Heating & Scarifying Treatment
 - Prime Coat, Tack Coat & Rejuvenating Agent (Section 407)
 - Seal Coat or Chip Seal (Section 409)
 - Other: _____

- Roadway Elements
- Curb and Gutter (Section 609)
 - Drop inlets - alignment and grades (Section 604)
 - Retaining Walls
 - Guard Rail (Section 606)
 - Sidewalk (Section 608)
 - Overlay Stationing
 - Other: _____

- (R-1) Riprap (Perm) (Section 506)
- Slope and Ditch Paving (Section 507)

- Minor Structures
- Structure Excavation limits (Section 206)
 - Culverts (Section 603)
 - Culverts w/ Headwalls and Wingwalls (Section 601)
 - Concrete Box Culverts w/ Headwalls and Wingwalls
 - Pipes (Section 603)
 - Sanitary Sewer
 - Storm Sewer
 - Water
 - Irrigation
 - Miscellaneous
 - Manholes (Section 604)
 - Inlets (Section 604)
 - Permanent Water Quality BMP (Section 208)
 - Other: _____

- Major Structures - Overhead Signs (Section 614), Concrete Box Culverts, Bridges - and all other structures assigned a structure number
- Structure Excavation limits (Section 206)
 - Concrete Box Culverts (Section 603) w/ Headwalls and Wingwalls (Section 601)
 - Piling locations and cut off elevations (Section 502)
 - Caisson locations and elevations (Section 503)
 - Footing locations, alignment, and elevations
 - Abutment/Pier locations, alignment, and elevations
 - Wingwall skew angles/offsets
 - Structural concrete form locations
 - Substructure As-constructed survey required for Bridges (Subsection 601.12) and Overhead signs (S-614-50)
 - Bridge expansion joint(s) alignment and grade (longitudinal and transverse)
 - Deck grades at Girder 10th or "n" th point locations and elevations
 - Slope and Ditch Paving (Section 507)
 - Other: _____

- Fencing (Section 607)
- Temporary
 - Permanent
 - Sound Barrier
 - Other: _____

- Delineators (Section 612)
- Temporary
 - Permanent

- Lighting (Section 613) and Traffic Control Devices (Permanent) (Section 614)
- Signal pole locations and elevations
 - Light pole locations and elevations
 - Sign locations
 - Field verify sign post locations, elevations, and lengths before fabrication.
 - Other: _____

(R-1)

Pavements	Grid (Y/N)	Special Interval	Special Offset
N	-	-	-
N	-	-	-
-	-	-	-
-	-	-	-
-	-	-	-

Curb & Gutter	Tangent Interval	Curve Interval	Special Offset
-	-	-	-

Stationing	Left Interval	Center Interval	Right Interval
-	-	-	-

- Pavement Marking (Section 627)
 - Stripping (Temp)
 - Stripping (Perm)
 - Symbols
 - Other: _____
- Temporary Lighting and Construction Traffic Control Devices (Section 630)
 - Signal pole locations and elevations (Temp)
 - Light pole locations and elevations (Temp)
 - Sign Locations (Temp)
 - Other: _____
- All Easements (Temp Staking by P.L.S. Only)
- Right of Way (Temp Staking by P.L.S. Only)

WORK PERFORMED BY THE CONTRACTOR'S SURVEYOR UNDER SECTION 629:

- Monumentation (Section 629)
 - Control
 - Right of Way
 - Land corners, Aliquot corners
 - Easements
 - Reference the specified existing monuments: ** _____
 - Replace the specified existing monuments: ** _____
 - Locate monuments. It is estimated _____ hours are required.

NOTE: All 629 items shall include adequate research, calculations, and evaluations of evidence for monuments to be set.
 ** A Tabulation of Survey Monuments may be provided on the plans.

GENERAL NOTES:

- Unless indicated otherwise on this Survey Tabulation Sheet, all survey work and staking intervals shall be done in accordance with the latest edition of the CDOT Survey Manual.
- Adequate information for establishing lines, grades, and locations for all work items have been specified on the plans. Any additional information required to stake the item or element shall be generated by the Contractor's surveyor.
- The Contractor's surveyor shall provide an estimate of the man-hours necessary to complete the work items indicated on this sheet. A copy of this sheet, with the estimated man-hours written on the blank line to the left of the specified items, shall be submitted with the Survey Schedule to the Engineer days prior to the Presurvey Conference - Construction Survey.
- Stakes and Monuments which are damaged or destroyed by the progress of construction shall be replaced by the Contractor at no additional cost to the Department.
- The Contractor shall furnish an As Staked (or 3D Design Modeling Electronic Files) Earthwork Quantity report to the Engineer prior to completion of twenty percent (20%) of the planned earthwork in any phase as per the CDOT Survey Manual. A printed copy of the As Staked (or 3D Design Modeling Electronic Files) Earthwork data report and a computer disk with that information on it, in the specified format shall be submitted to the Engineer. The Contractor shall field verify original ground cross sections at a maximum 500 feet intervals.
- Prior to beginning work on any subsequent operation, such as placing base course or paving, the Contractor shall certify in writing to the Engineer that the final grade is within specified tolerance.
- The Contractor's surveyor shall perform all field surveying and calculations necessary to tie plan grades into field grades.
- The Contractor shall coordinate construction staking on the project with any utility work.
- Fieldbooks shall contain daily records of points set and or measurements observed. The information recorded shall contain: date, crew members' names, point no., description, staking information, and sketches. If the survey information is collected electronically, information recorded shall be provided to the Project Engineer in a hard copy format that is intuitive, clear and related to the supplemental information recorded in the field books. All linear surveys, such as slope stakes and blue tops, shall have the station and offset information related to the measured information. Non-linear surveys such as structures staking shall have sketches relating electronic information, such as point numbers, to the sketch.

- (R-1) 10. The Contractor's surveyor shall submit the following fieldbooks to the Engineer:
- Horizontal Control (Primary & Secondary)
 - Vertical Control (i.e. Benchmarks)
 - Property Pin Ties
 - Horizontal Alignment
 - Grading
 - Slope Staking
 - Minor Structures
 - Major Structures
 - One fieldbook for each work category shown on this sheet
 - Other Fieldbook(s): _____



11. The Contractor's surveyor shall submit the following (prior to surveying on the project) to the Engineer:
- All required Instrument Calibrations

I:\2017\2017-211-GWSSOMIDLAND\001-MIDLAND4MILERD27THST-H-DWGS\CIVIL\PS-SHEETSET\SMDLAND-ADMIN.DWG Plotted: 10/29/2020 5:10 PM By: Mike Fowler


Computer File Information		Sheet Revisions			As Constructed		South Midland Ave. Improvements Survey Tabulation Sheet			Project No./Code	
Print Date: 10/29/20		Rev.	Date	Comments	Init.	No Revisions:	-	Engineer: MDF			No.: BUILD M535-006
Last Modification Date: 10/29/20		1	10.29.20	Revised Items	MDF	Revised:	-	Structure: ---			Code: 22933
Drawing File Name: SMidland-Admin						Void:	-	Drawn By: AMC			Sheet Number: 24
Autocad Ver. 2018 Scale: As Shown Units: English								Sheet Subset: TABS			Subset Sheets: 8 of 8
SGM Project No.: 2017-211.001 Quality Control: RGN											



I:\2017\2017-211-GWSSOMIDLAND\001-MIDLAND4MILLERD27THST\H-DWG\CIVIL\PS-SHEETSET\SMIDLAND-WALLS-REDIROCK.DWG Plotted: 10/30/2020 9:12 AM By: Mike Fowler

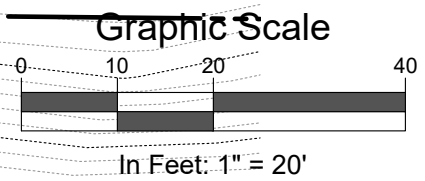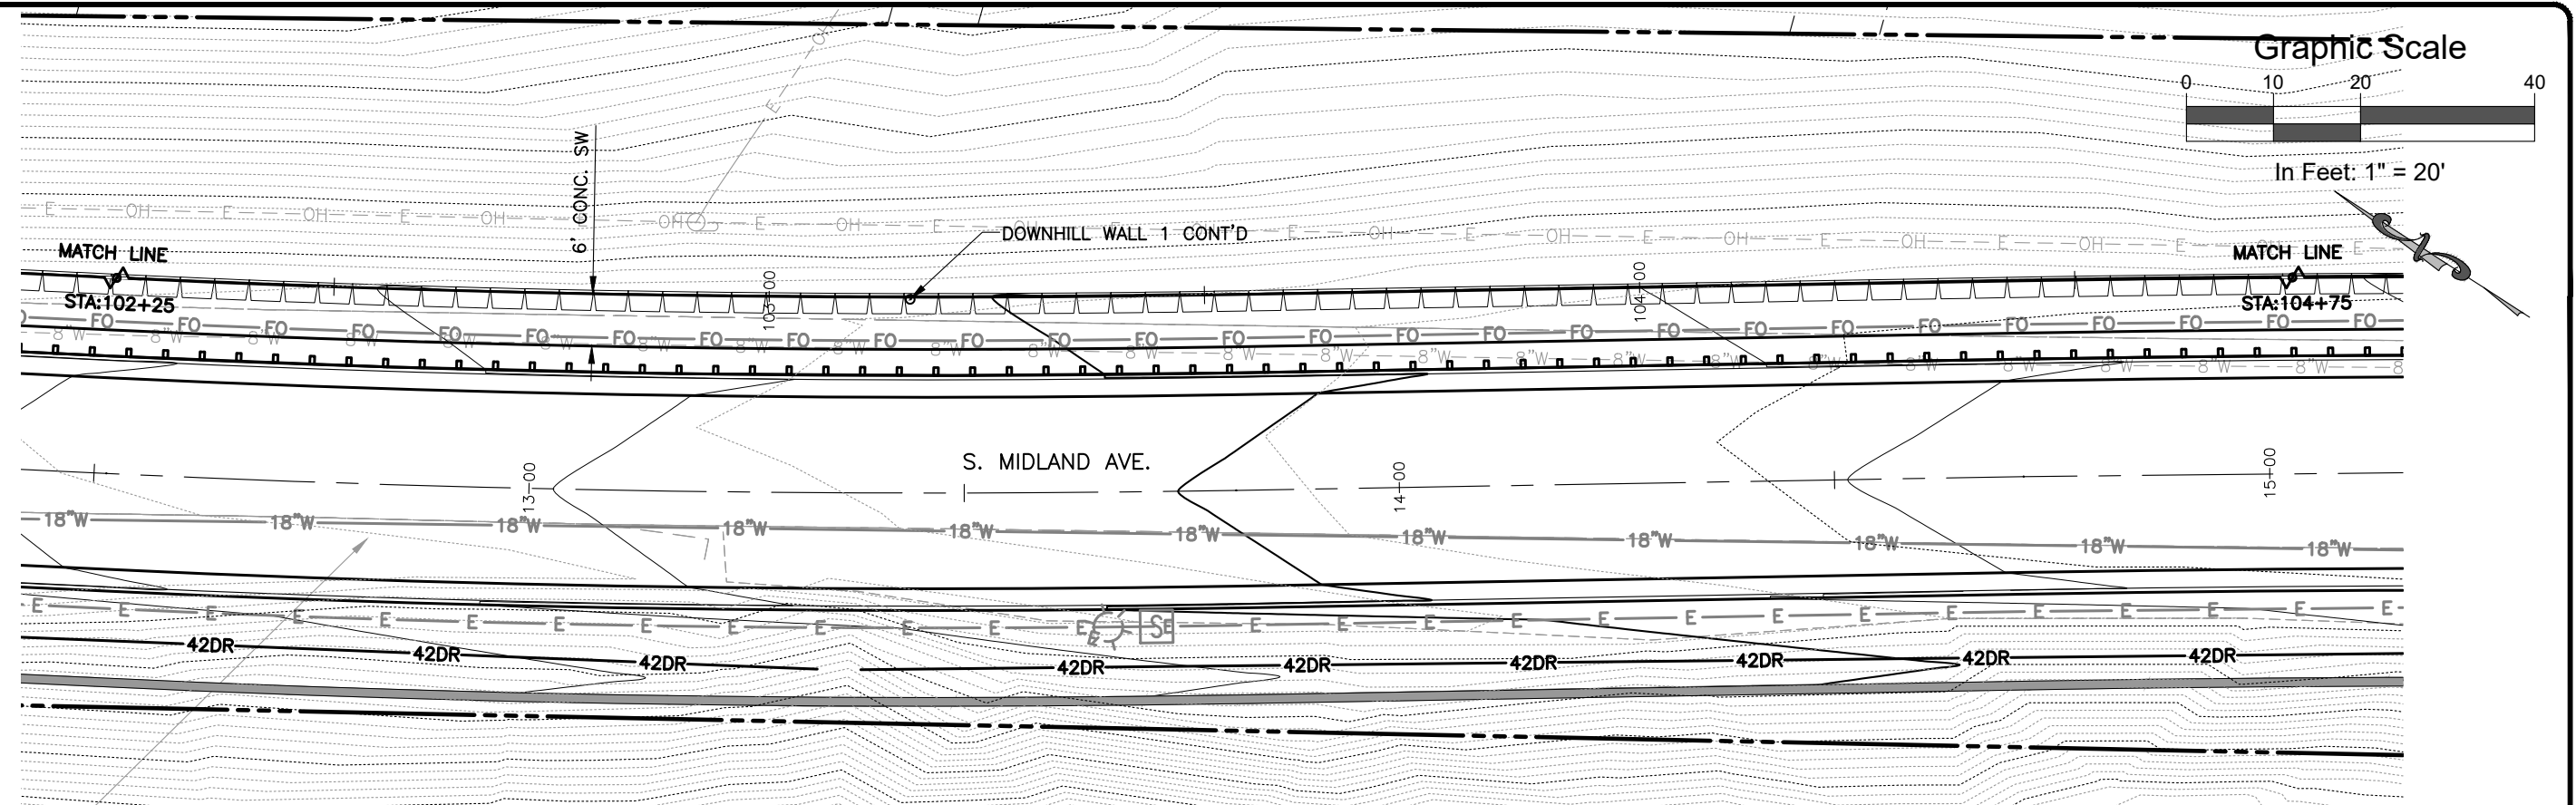

NOTE:
1. PEDESTRIAN RAIL NOT SHOWN, FOR CLARITY.

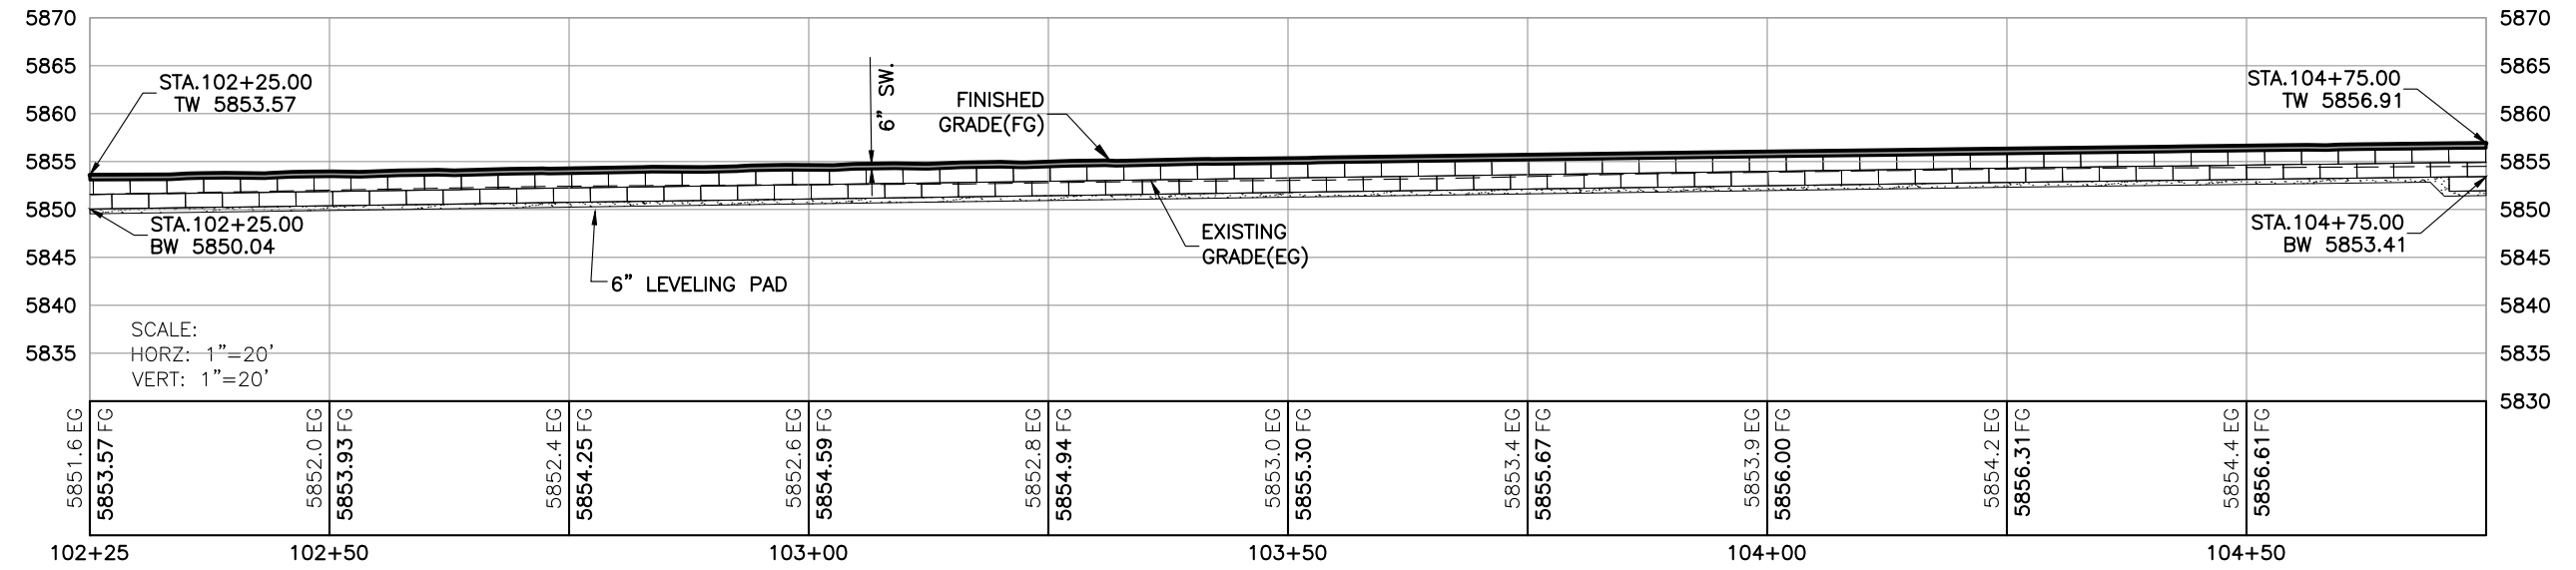

Computer File Information		Sheet Revisions				 118 West Sixth Street, Suite 200 Glenwood Springs, CO 81601 970.945.1004 www.sgm-inc.com	As Constructed		South Midland Ave. Improvements		Project No./Code	
Print Date: 10/30/20	Last Modification Date: 4/23/2019	Rev.	Date	Comments			Init.	No Revisions:	-	Downhill Wall 1 (2)		No.:
Drawing File Name: SMidland-Walls-RediRock	Autocad Ver. 2018 Scale: As Shown Units: English	1	10.30.20	Corrected Limits of Plan View	MDF	Revised:	-	Engineer:	MDF	Structure	---	Code: 22933
SGM Project No.: 2017-211.001 Quality Control: RGN						Void:	-	Drawn By:	AMC	Numbers	---	Sheet Number: 163
							Sheet Subset:	WALLS	Subset Sheets:	7 of 47		